


Project
A COMMUNICATIONS FACILITY FOR PARAGON CABLE
 Troutdale Oregon

MM
 MacDonald Miller
 Company, Inc.
 1240 SE 12th Avenue
 Portland, OR 97214
 Phone: (503) 230-8991
 Fax: (503) 736-0597

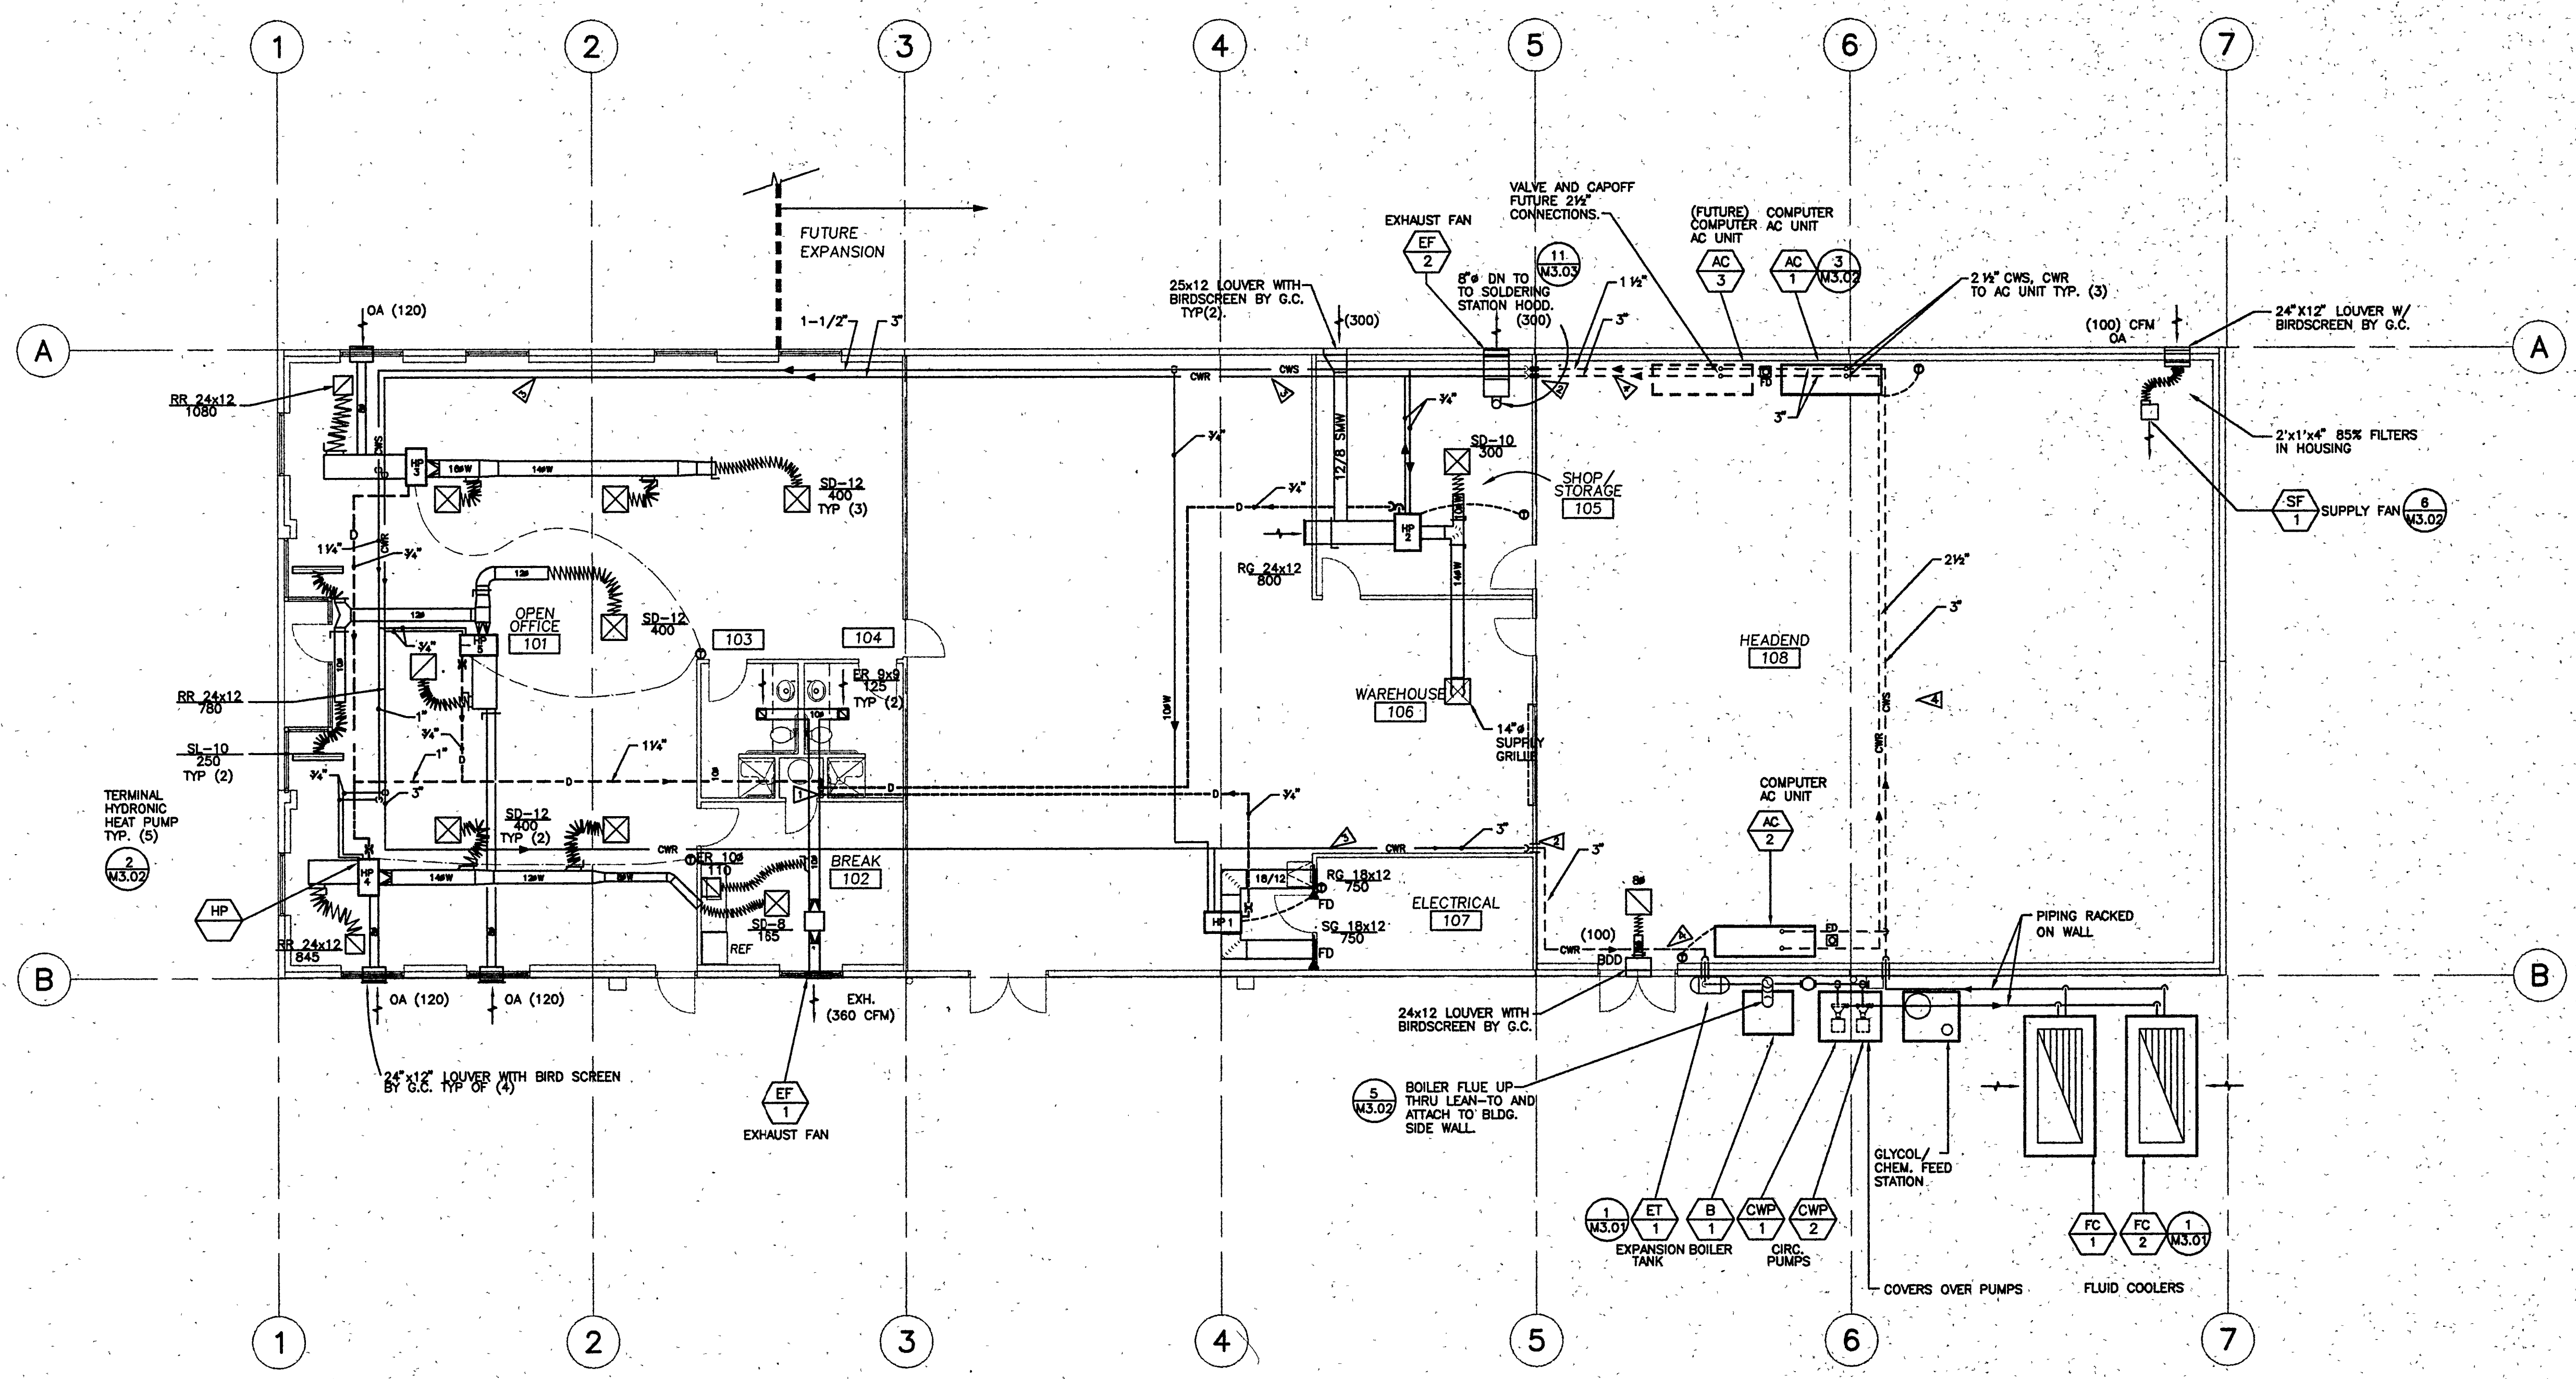

- FLAG NOTES**
- CONDENSATE DRAIN LINES DN, TERMINATE WITH 1" AIRGAP AT FFD.
 - SLEEVE PIPE THRU VERTICAL WALL OF SUB-FLOOR. PROVIDE SCH 40 SLEEVE (1) DIA G.T. PIPING AND LINK-SEAL. COORD. PIPE SLEEVE WITH G.C. PRIOR TO POURING OF CONCRETE.
 - PIPING RUN AT HIGH LEVEL BELOW ROOF STRUCTURE.
 - PIPING RUN IN 24" DEEP ELECTRICAL/PLENUM SUBFLOOR. COORDINATE INSTALLATION WITH PIPING DRAIN PAN SHOWN ON DWG P2.11.

MAIN LEVEL PLAN-HVAC
 Scale: 1/8" = 1'-0"

- 1 BLDG PERMIT 4/17/97
- 2 AS-BUILT 11/9/97

SHEET TITLE:
MAIN LEVEL PLAN-HVAC

DATE: 11/03/97
 DRAWN BY: R. SMITH
 CHECKED BY: I. SIMKIN

SHEET
M2.11
 JOB NO. **MM5209**