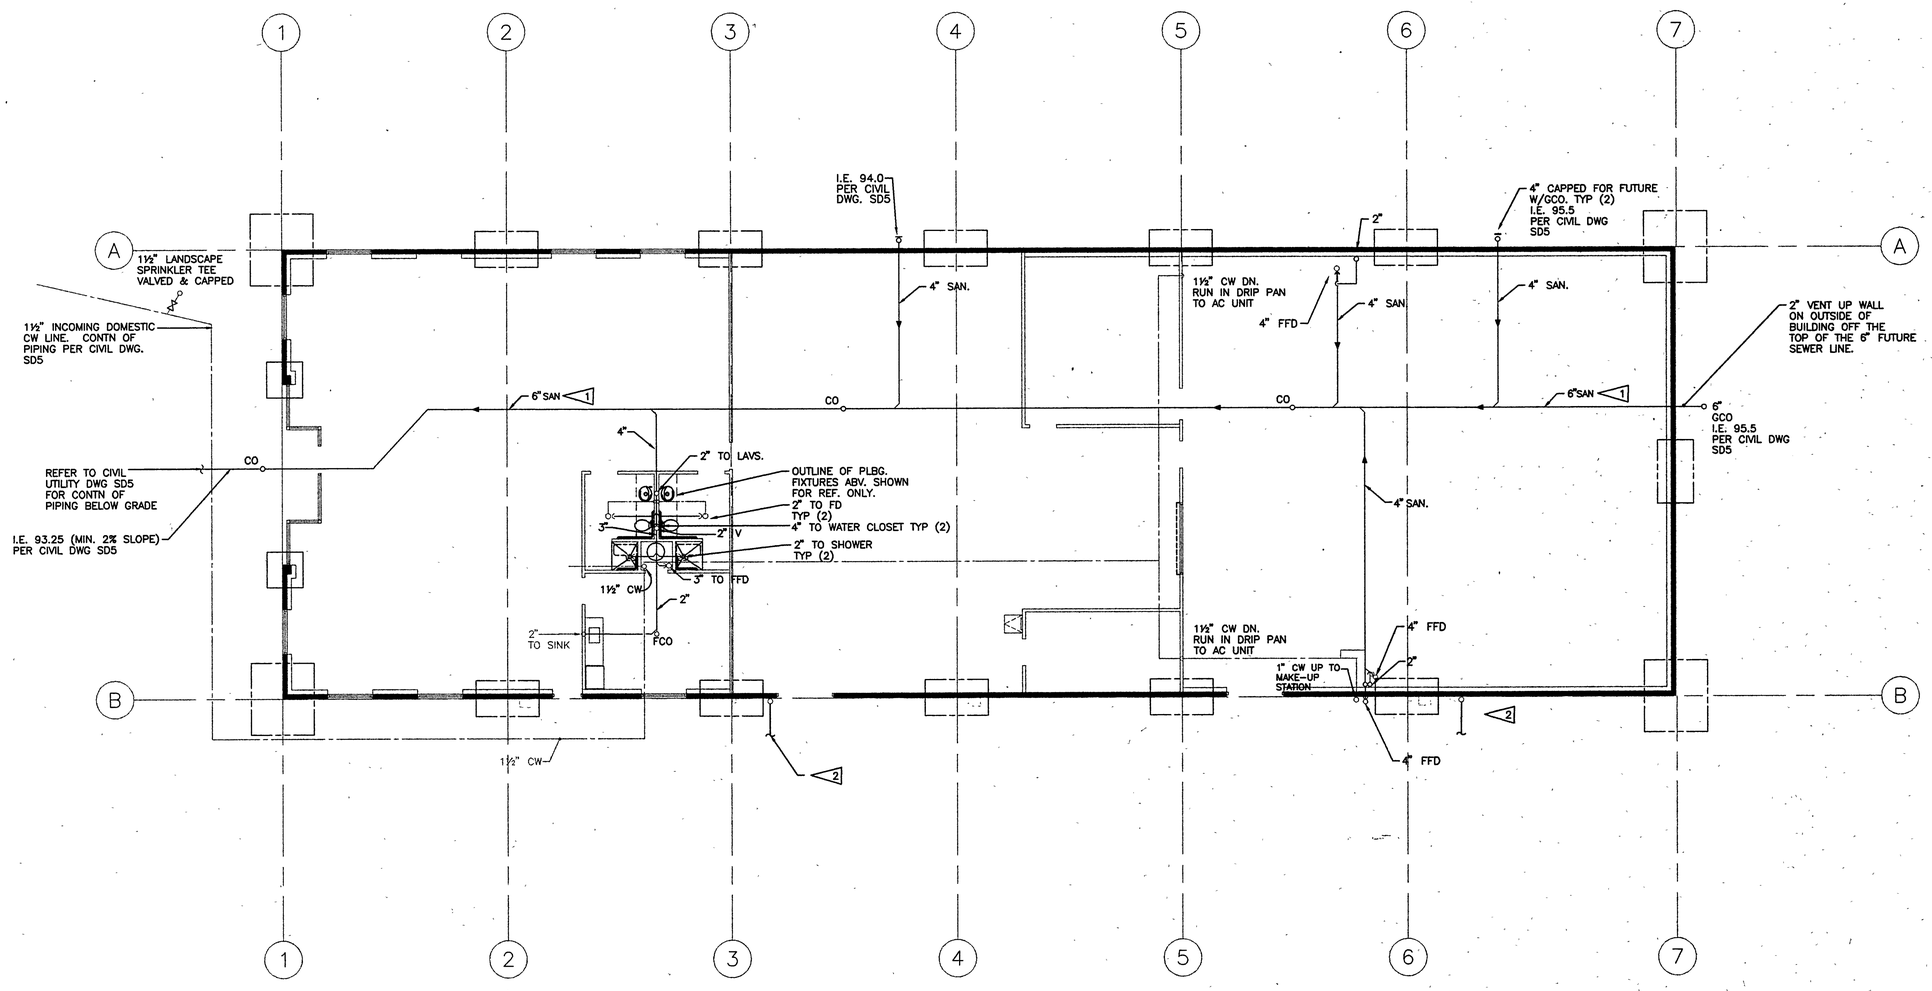

FLAG NOTES:

1. 6" SANITARY MAIN SIZE PER OWNERS DIRECTION DWG SD5
2. 4" ROOF DRAINAGE LEADER. REFER TO CIVIL DWG. SD5 FOR CONTINUATION OF PIPING BELOW GRADE.

FOUNDATION LEVEL PLAN–PLUMBING

Scale: 1/8" = 1'-0"

AS-BUILT

GROUP MACKENZIE
Civil Engineering
Structural Engineering
Transportation Planning
Architecture
Interior Design
Land Use Planning
0690 SW Bancroft St / PO Box 69039 Portland, OR 97239-0039
Tel: 503.224.1970 Fax: 503.226.1285

Project
A COMMUNICATIONS FACILITY FOR PARAGON CABLE
Troutdale Oregon

MacDonald Miller Company, Inc.
1240 SE 12th Avenue
Portland, OR 97214
Phone: (503) 230-8991
Fax: (503) 736-0597

1	BLDG PERMIT 4/17/97
2	AS-BUILT 11/3/97

SHEET TITLE:
FOUNDATION LEVEL PLAN-PLUMBING

DATE: 11/03/97
DRAWN BY: R. SMITH
CHECKED BY: I. SIMKIN

SHEET
P2.01

JOB NO MM#5209

e: C:\mmjobs\Paragon\P\P201, Date: 11/14/97, 09:24:16 Username: Testing annotation